

RECEIVED FEB 27 2019

RECEIVED FEB 27 2019

To: Max Slater 412-261-3943

From: Desiree Singleton
Harvest moon
Coffee & Chocolates

cell # 724-216-7975

HARVEST MOON COFFEE & CHOCOLATES

724-216-7975
harvestmoonchocolates
@gmail.com

206 Corbet Street
Tarentum, PA 15084

February 25, 2019

Director, Allegheny County Health Department
Food Safety Program
3901 Penn Avenue
Building 1
Pittsburgh, PA 15224-1318

Dear Food Safety Program,
Harvest Moon Coffee & Chocolates, LLC requests approval for a variance from the conditions set forth in section 316 of Article III Food Safety Rules and Regulations.

This is my written appeal:

I had my architect resubmit to me the proposed first floor drawings. These drawings were corrected and seating in the rear retail area was removed. The new count for seating is now 11 seats plus the number of employees.

Sincerely yours,


Desiree Singleton

Plan review #18-472-js

FIRST FLOOR: SEATING

 FIRST FLOOR: KITCHEN

 FIRST FLOOR: BUSINESS AREA

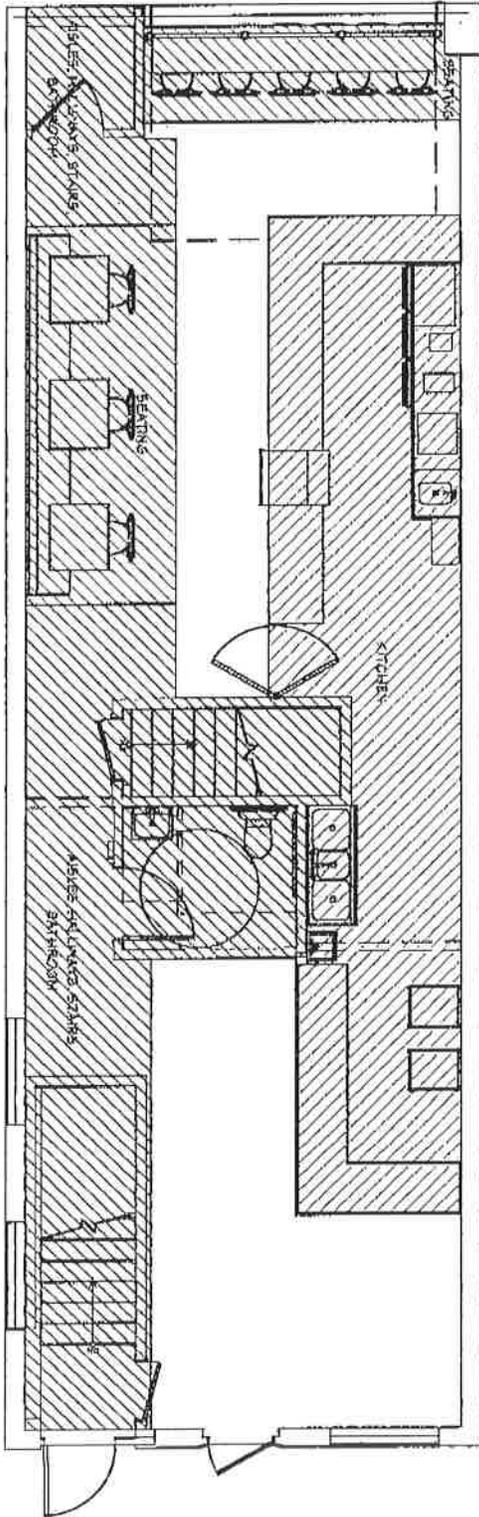

PROPOSED FIRST FLOOR

SCALE = 1/8" = 1'-0"

RLHollibaugh
 Design
 P.O. Box 12
 Russellton, PA 15076
 724-931-7395
 www.RLHollibaugh.com

If you think you can't make
 the world a better place
 with your work,
 at least make sure you
 don't make it worse.
 -Herman Hertzberger

HARVEST MOON COFFEE & CHOCOLATES, L.L.C.
 206 CORBET STREET
 TARENTUM, PA 15084

Date: **FEBRUARY 25, 2019**
 Sheet: **A-1 OF 1**

COUNTY OF



ALLEGHENY

RICH FITZGERALD
COUNTY EXECUTIVE

February 19, 2019

Harvest Moon Coffee & Chocolates LLC
c/o Desiree Singleton
206 Corbett Street
Tarentum, PA 15084

RE: Request for Variance
Plan Review #18-472-js
Harvest Moon Coffee & Chocolates
206 Corbett Street
- Tarentum

Dear Ms. Singleton:


This letter is in response to your request for a variance from Article III, the Allegheny County Health Department rules and regulations governing "Food Safety", sections 316.1C and D - "Toilet Rooms" and section 315 - "Plumbing". Article III requires for the provision of separate male and female toilet rooms for patrons of food facilities where seating is provided and that such toilet rooms cannot be accessed through food preparation or food storage areas.

Your request states that you request to have 16 seats with access to a "handicapped accessible restroom" and that the interior space is limited.

It is the decision of this office to deny your request for a variance. However, this variance denial applies only to the conditions identified in your request for the subject facility. Should you desire to alter the conditions of your request, such as reducing your total occupancy to "15" (number of seats plus number of employees), a new written request is required and may be submitted for review.

Pursuant to Article XI, entitled "Hearings and Appeals", you are hereby notified that you have thirty (30) days after issuance of this notice in which to file a written appeal. The appeal shall be filed in the office of the Director, 542 Fourth Avenue, Pittsburgh, PA 15219. In the event that an appeal is not filed within thirty (30) days from the date of this order, the within action shall become final.

Respectfully,

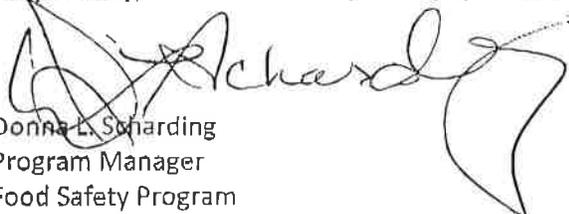
Donna L. Scharding
Program Manager
Food Safety Program



KAREN HACKER, MD, MPH, DIRECTOR
ALLEGHENY COUNTY HEALTH DEPARTMENT

FOOD SAFETY PROGRAM

3901 PENN AVENUE • BUILDING 1 • PITTSBURGH, PA 15224-1318
PHONE: 412.578.8044 • FAX: 412.578.8190 • WWW.ACHD.NET

